


AS BUILT

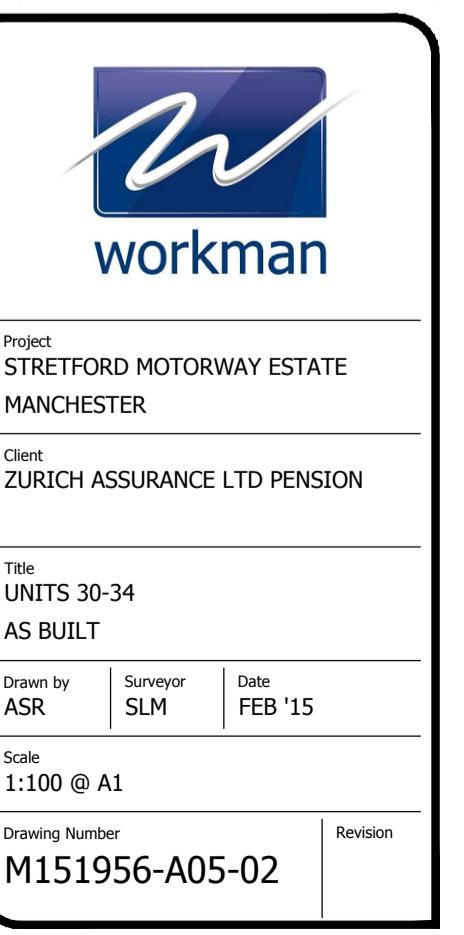

UNIT 30-34 - AS BUILT @ 1:100