


NB | Responsibility is not accepted for errors made by others scaling from this drawing. All construction information should be taken from figured dimensions only

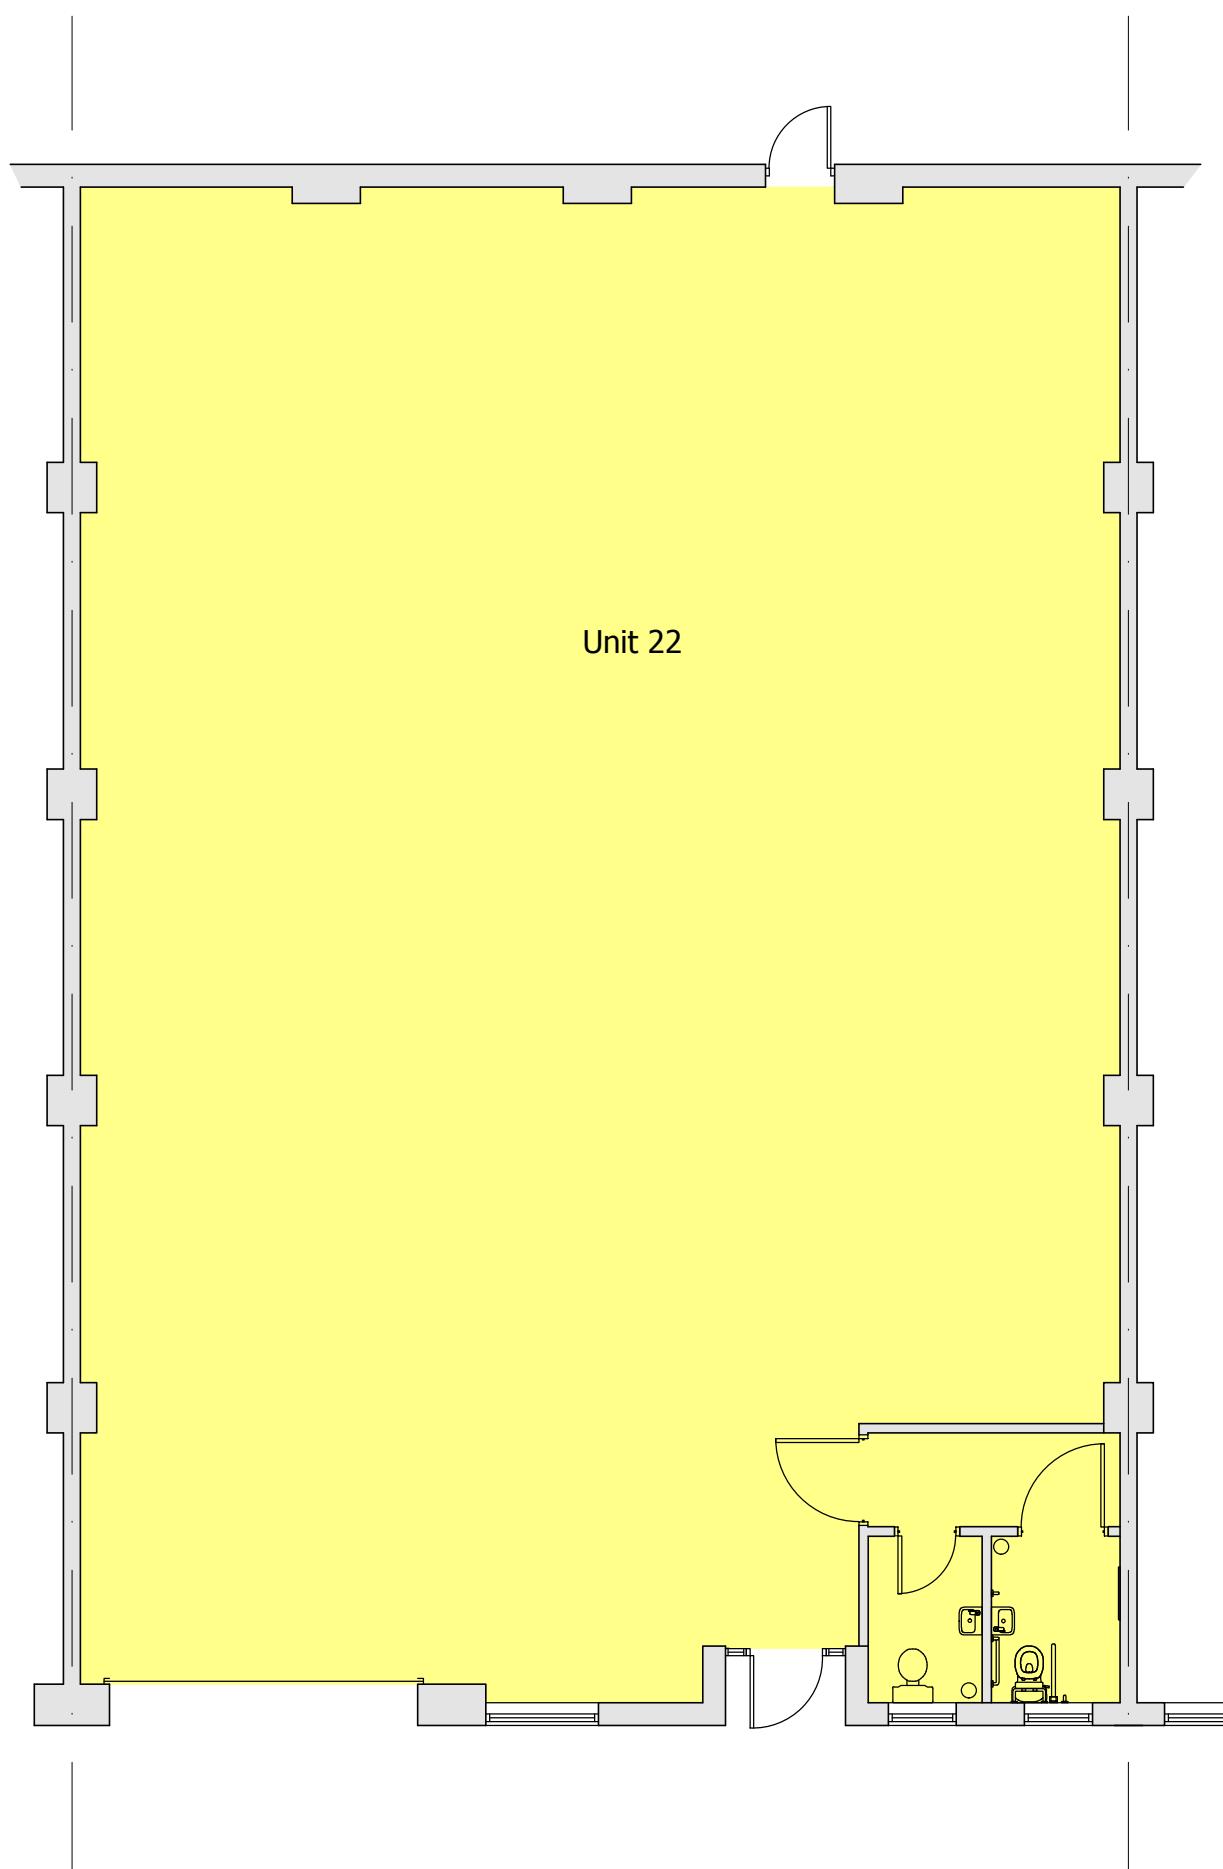

Unit 22

Workman LLP take no responsibility for the accuracy or information taken from this drawing.
Do NOT scale from this drawing.

AS BUILT

Rev	Description	By	Date
-----	-------------	----	------



workman

Project
STRETFORD MOTORWAY ESTATE
MANCHESTER

Client
ZURICH ASSURANCE LTD

Title
UNIT 22
AS BUILT

Drawn by
ASR | Surveyor
SLM | Date
JAN '17

Scale
1:100 @ A3

Drawing Number
M151956-A05-03 | Revision

UNIT 22 - AS BUILT @ 1:100