


NB | Responsibility is not accepted for errors made by others scaling from this drawing. All construction information should be taken from figured dimensions only

A3

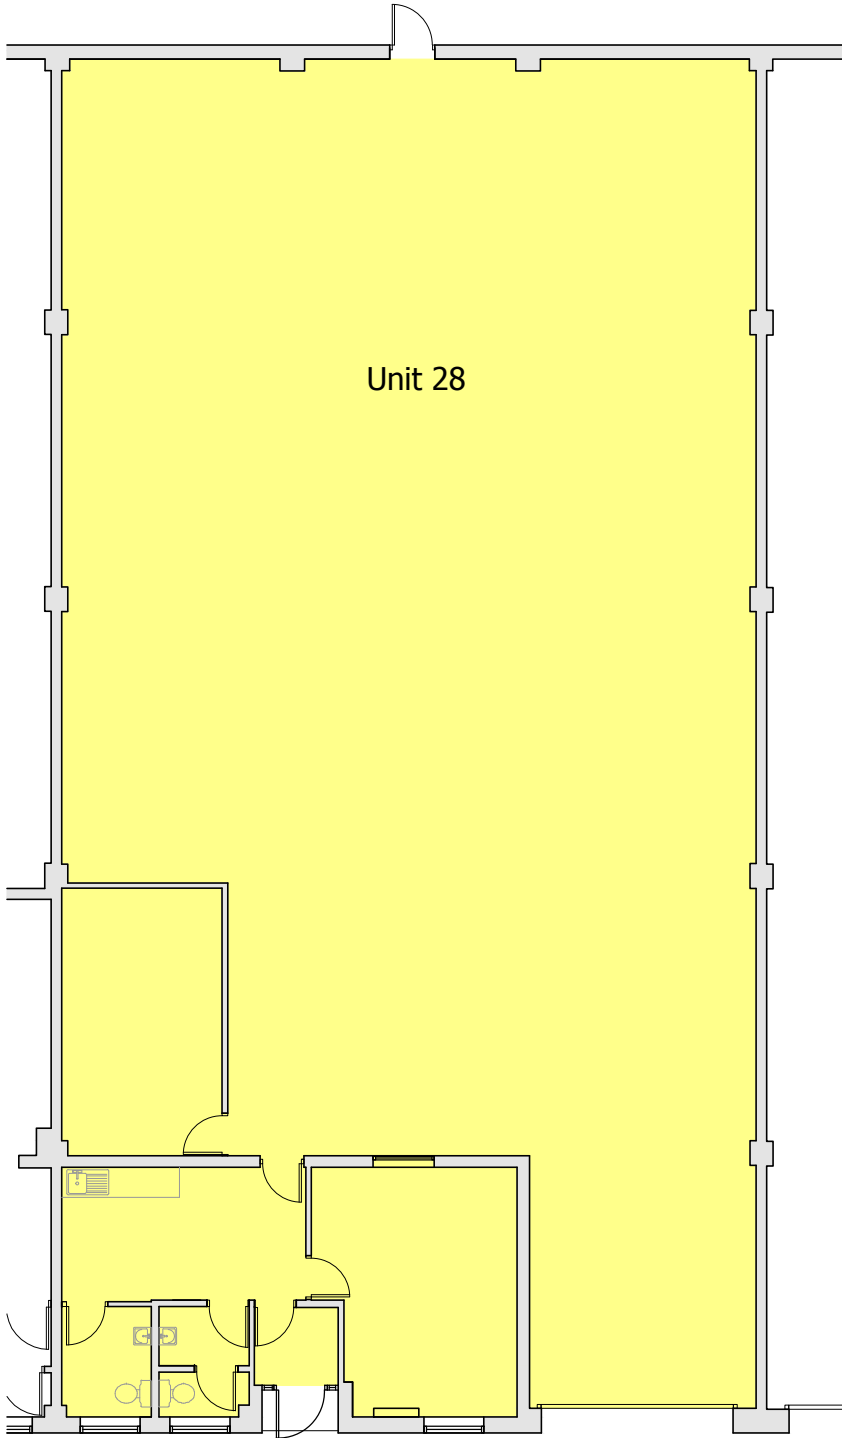

AS BUILT

Rev	Description	By	Date
-----	-------------	----	------



Project
STRETFORD MOTORWAY ESTATE
MANCHESTER

Client
ZURICH ASSURANCE LTD

Title
UNIT 28
AS BUILT

Drawn by	Surveyor	Date
ASR	SLM	FEB '17

Scale
1:150 @ A3

Drawing Number	Revision
M151956-A05-07	