


NB | Responsibility is not accepted for errors made by others scaling from this drawing. All construction information should be taken from figured dimensions only

A3

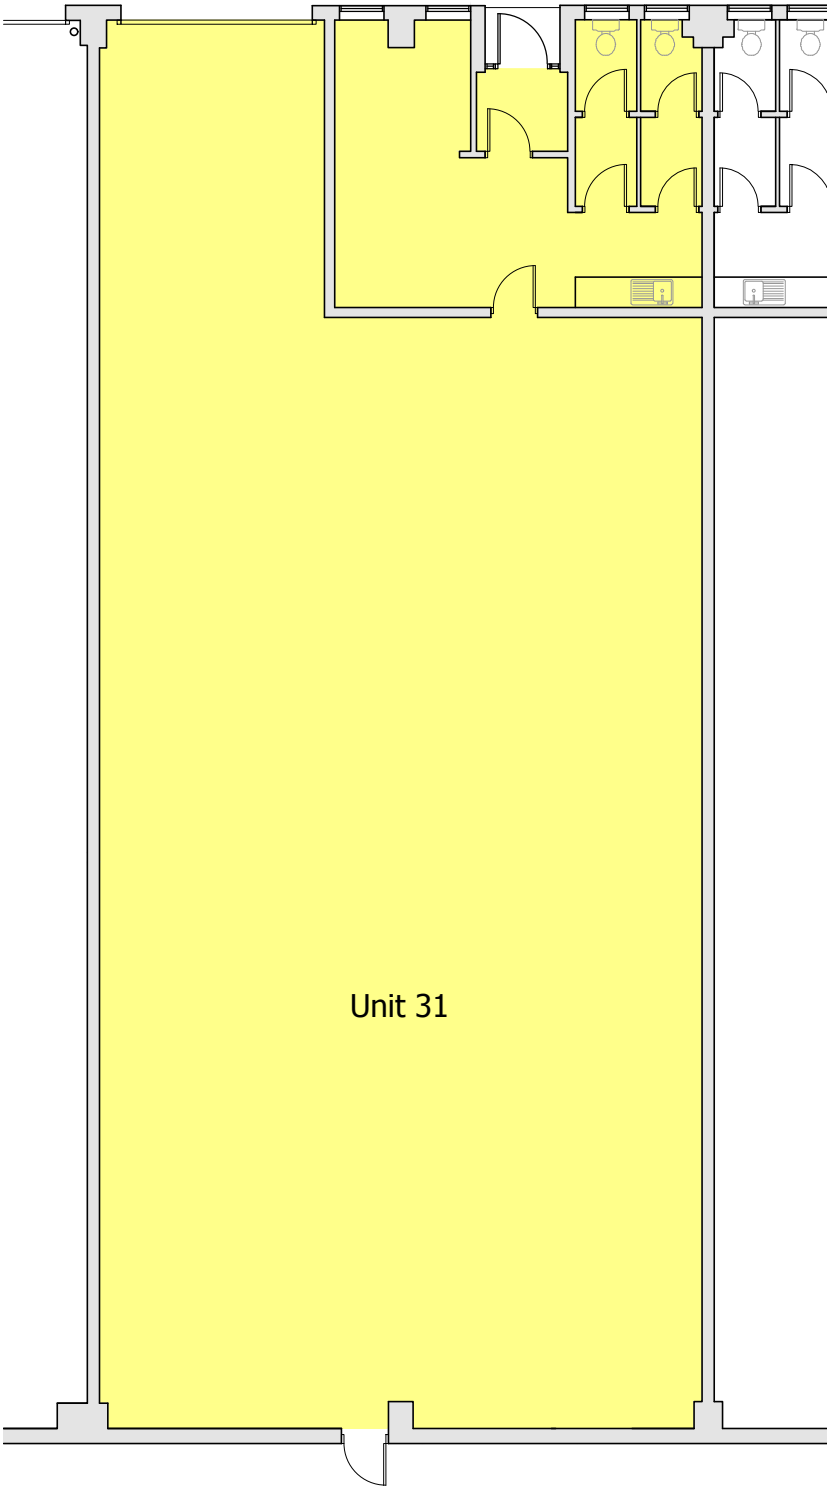

AS BUILT

Rev	Description	By	Date
-----	-------------	----	------



Project
STRETFORD MOTORWAY ESTATE
MANCHESTER

Client
ZURICH ASSURANCE LTD

Title
UNIT 31
AS BUILT

Drawn by ASR	Surveyor SLM	Date FEB '17
-----------------	-----------------	-----------------

Scale
1:150 @ A3

Drawing Number M151956-A05-10	Revision
----------------------------------	----------