


NB | Responsibility is not accepted for errors made by others scaling from this drawing. All construction information should be taken from figured dimensions only

A3

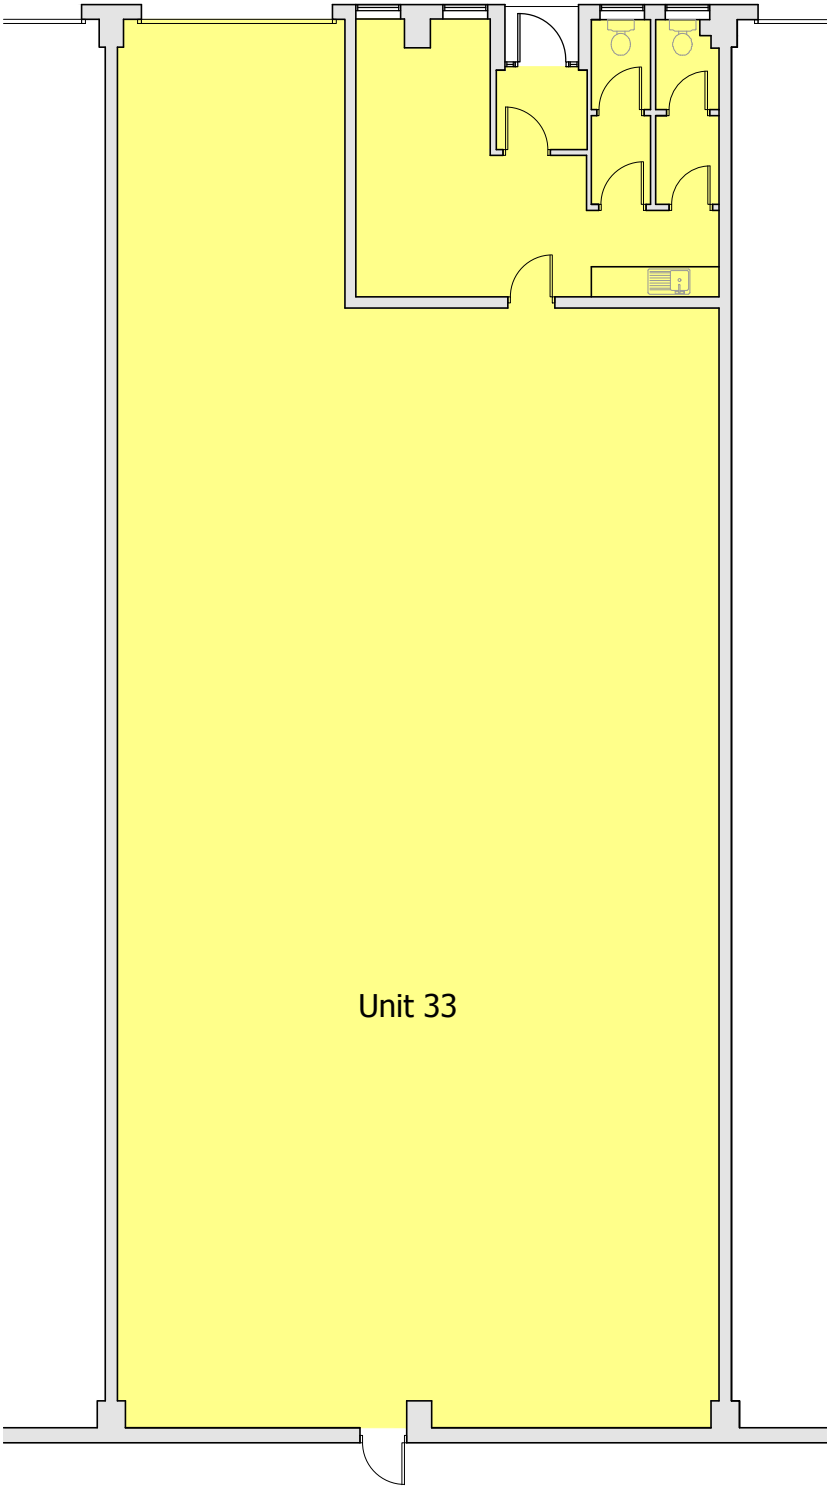

AS BUILT

Rev	Description	By	Date



Project
STRETFORD MOTORWAY ESTATE
MANCHESTER

Client
ZURICH ASSURANCE LTD

Title
UNIT 33
AS BUILT

Drawn by	Surveyor	Date
ASR	SLM	FEB '17

Scale
1:150 @ A3

Drawing Number	Revision
M151956-A05-12	

Workman LLP take no responsibility for the accuracy or information taken from this drawing. Do NOT scale from this plan.